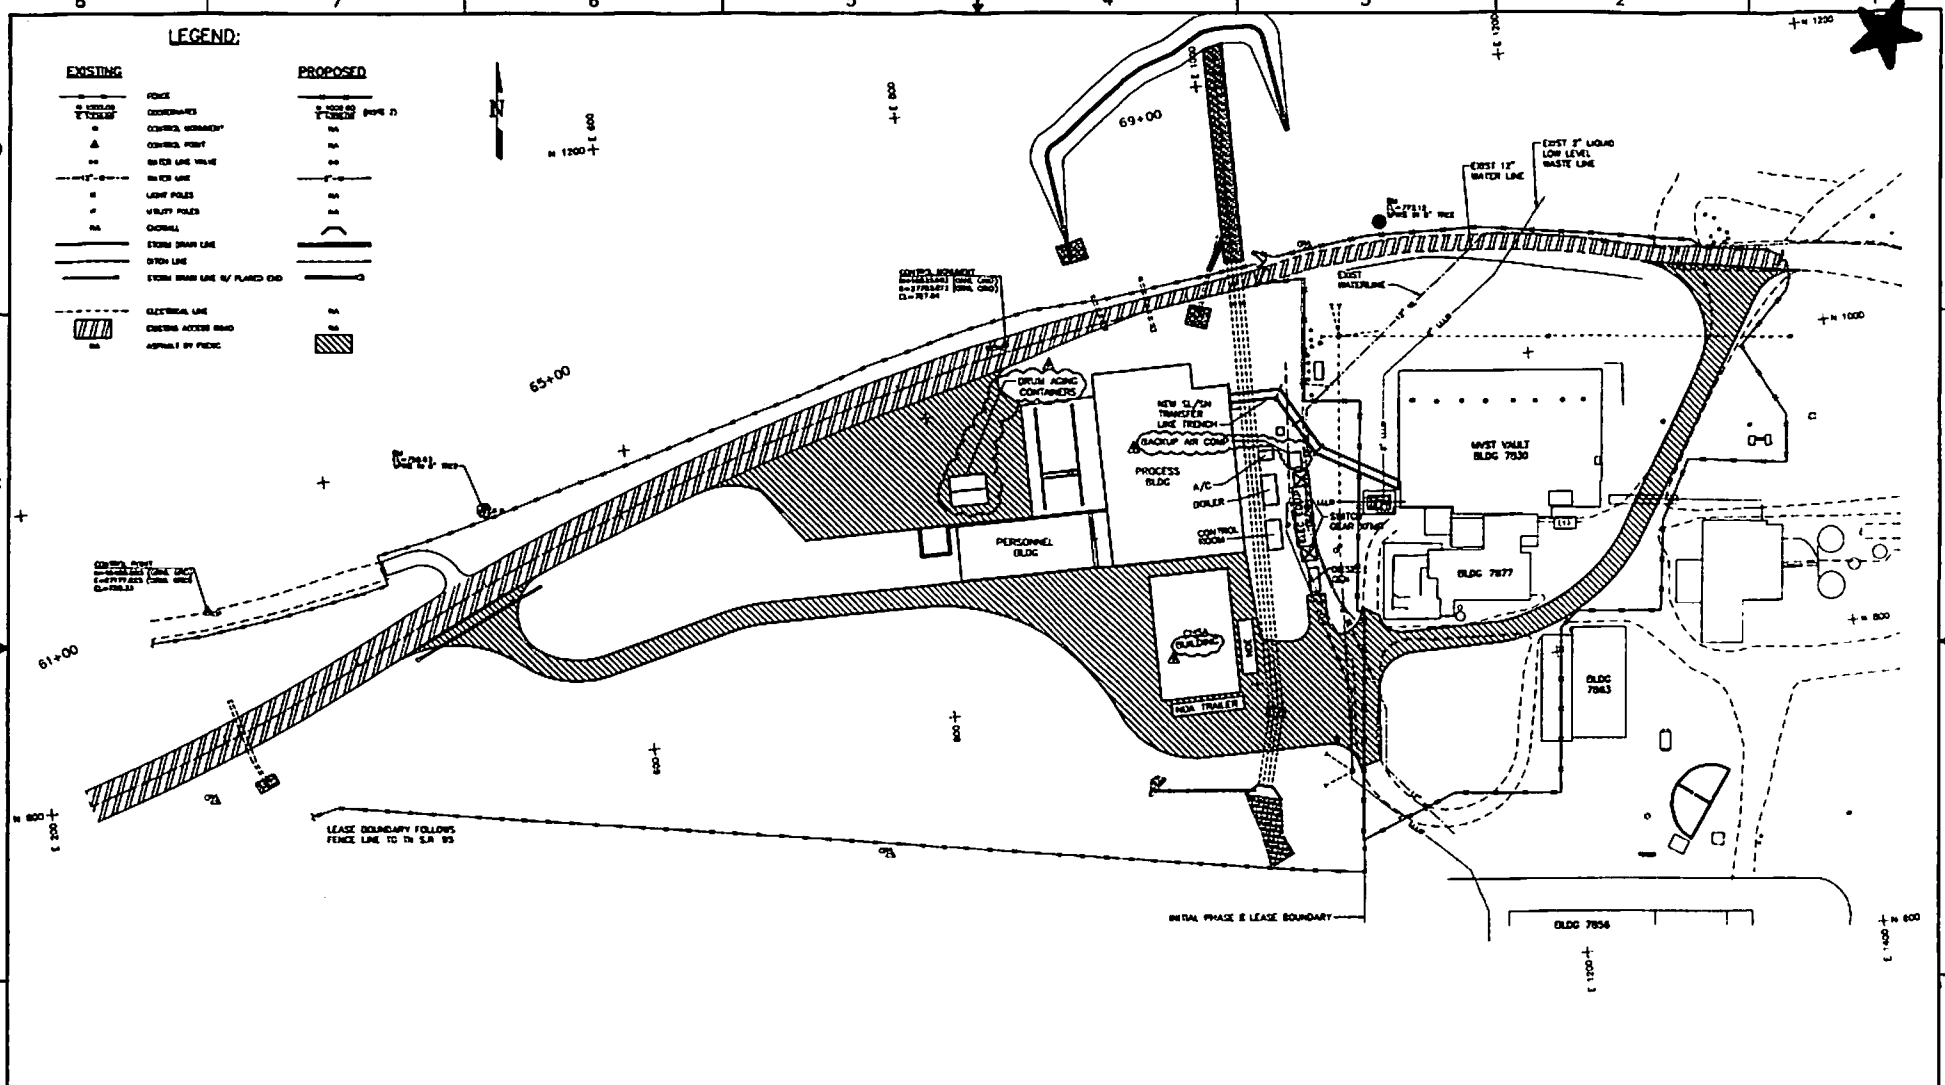

FWENC LEASE BOUNDARIES
CORRESPOND TO FENCE BOUNDARIES

NOTES:
1. BUILDING LOCATIONS AND ASPHALT AREAS MAY BE ADJUSTED DURING PHASE II
2. NE CORNER OF PROCESSING BUILDING:
N1000
E1000

REV	DATE	BY	CHK'D	APP'D	DESCRIPTION/ISSUE
8	[illegible]	[illegible]	NG	[illegible]	REFLECT CH SOLID WASTE OPS. AND AS-BUILT
6	3/3/00	JCM	NG	NG	REPLACED TRUPACT WITH CHSA STRUCTURE AND REVISED RIPRAP
4	1/11/00	JAT	BAR	CW	REVISED TRANSFER LINE TRENCH
3	1/8/00	JAT	BAR	CW	REVISED RETAINING WALL, ADDED BERM, SL & SN TRANSFER LINES, NOTES & REVISED LEGEND
2	12/1/00	JAT	CW	BAR	REVISED FENCE LOCATION
1	1/8/00	JAT	CW	BAR	REVISED FENCE, CLARIFIED ASPHALT LOCATION

DRAWN BY	JAT	7/21/00
DESIGNED BY	JCW	7/21/00
CHECKED BY	JTH	7/21/00
APPROVED BY	BAR	7/21/00

FOSTER WHEELER
FOSTER WHEELER ENVIRONMENTAL CORPORATION

TRU/ALPHA WASTE TREAT. PROJ.
LEASE BOUNDARIES

SIZE	SCALE	DWG. NO.	REV
D	1"=60'	T-CM-FW-D-CE-901	6