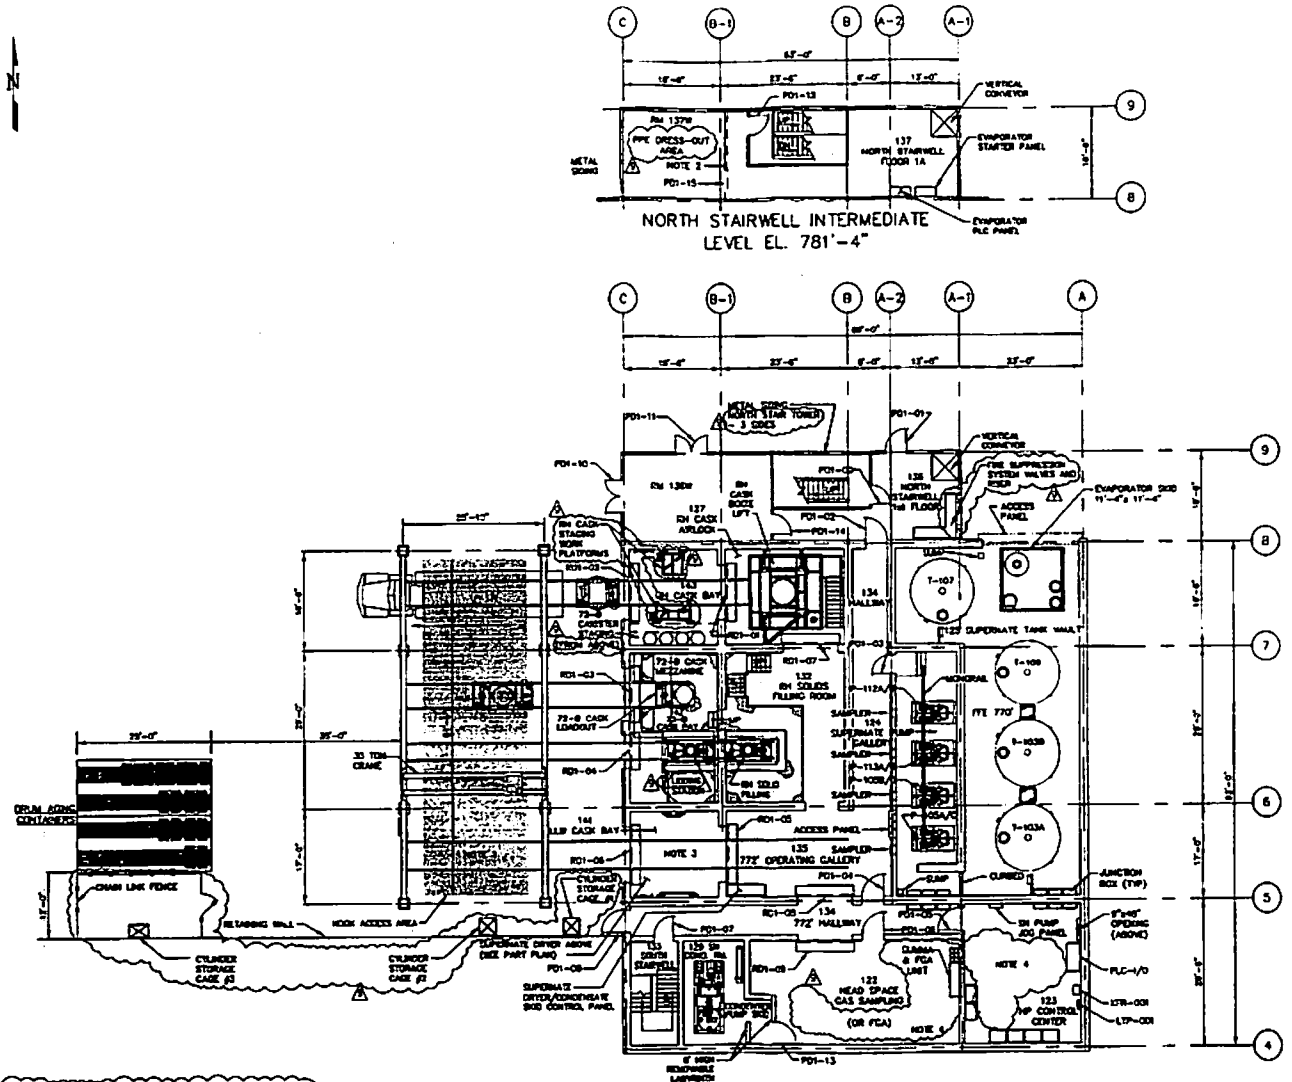

REVISION NOTES:

1. RH BUILDOUT REQUIREMENTS, INCORP. DCN-ME-194, ADD CYLINDER STORAGE CAGES.

REV	DATE	BY	CHK'D	APP'D	DESCRIPTION/ISSUE
9	[illegible]	[illegible]	[illegible]	[illegible]	SEE REVISION NOTES
8	7/21/98	JGH	EB	GW	INCORP. FCR-ME-345 & 251
7	4/16/98	JGH	MG	GW	REFLECT CH SOLID WASTE OPERATIONS
6	3/4/98	JGH	MG	AG	REVISED ROOM 122 FOR HEAD SPACE GAS SAMPLING
					ADDED DRUM AGING CONTAINERS
5	1/30/98	JP	CW	GW	GENERAL REVISION - ADDED MISCELLANEOUS PANELS

REV	DATE	BY	CHK'D	APP'D	DESCRIPTION/ISSUE
4	12/3/97	CC	JAL	GW	ADDED DWG T-411 & DOOR PD1-13, REVISED TO
					REFLECT PLANT FEATURES & AS-BUILT CONDITIONS
3	8/4/97	JAT	BAR	GW	REVISED DOOR SIZINGS
2	4/8/97	JAT	BAR	GW	REVISED TO REFLECT PURCHASED EQUIP.
1	12/1/96	JAT	MG	GW	REVISED RH CASK PLTFM, PD1-03 RD, ADDED
					CRANE OPERATING ENVELOPE

DESIGN BY	J. A. TADLER	DATE 12/1/00
DESIGNED BY	J. G. WAGNER	DATE 12/1/00
CHECKED BY	M. CHAGSARIAN	DATE 12/1/00
APPROVED BY	J. G. WAGNER	DATE 12/1/00
APPROVED BY		DATE

FOSTER WHEELER

FOSTER WHEELER ENVIRONMENTAL CORPORATION

TITLE: TRU/ALPHA WASTE TREAT. PROJ. 1ST FLOOR PLAN GENERAL ARRANGEMENT

SIZE D | SCALE 3/16"=1'-0" | SHEET 1 OF 1 | DWG. NO. T-CM-FW-D-AR-001 | REV 9

FILENAME T-CM-FW-D-AR-001

Uncontrolled Copy printed on 05-01-08, 13:20:46 hours.