NOTES:

1. PERSONNEL ELEV. APPROX. ELEV. WILL BE ADJUSTED BASED ON MODULAR BLDG SUPPLIER.
2. DOOR PD2-33 FOR MANIPULATOR MAINTENANCE ACTIVITIES AND FIRE FIGHTER ACCESS ONLY.
3. DOOR PD2-34 FOR FIRE FIGHTER ACCESS ONLY.
4. RM. 532 CONVERTED TO OFFICES. FURNITURE LAYOUT AND OFFICE PARTITIONS FOR ILLUSTRATIVE PURPOSES ONLY.
5. SHIELD BLOCKS INSTALLED ADJACENT TO DOOR DURING DRYER OPERATIONS.
6. CONVEYOR COVERS NOT SHOWN.
7. ROLL-UP COVER INSTALLED ON OPENING IN PROCESS BUILDING WALL.
8. MINOR OPERATIONAL EQUIPMENT NOT SHOWN ON DRAWING OR MAY BE RELOCATED.

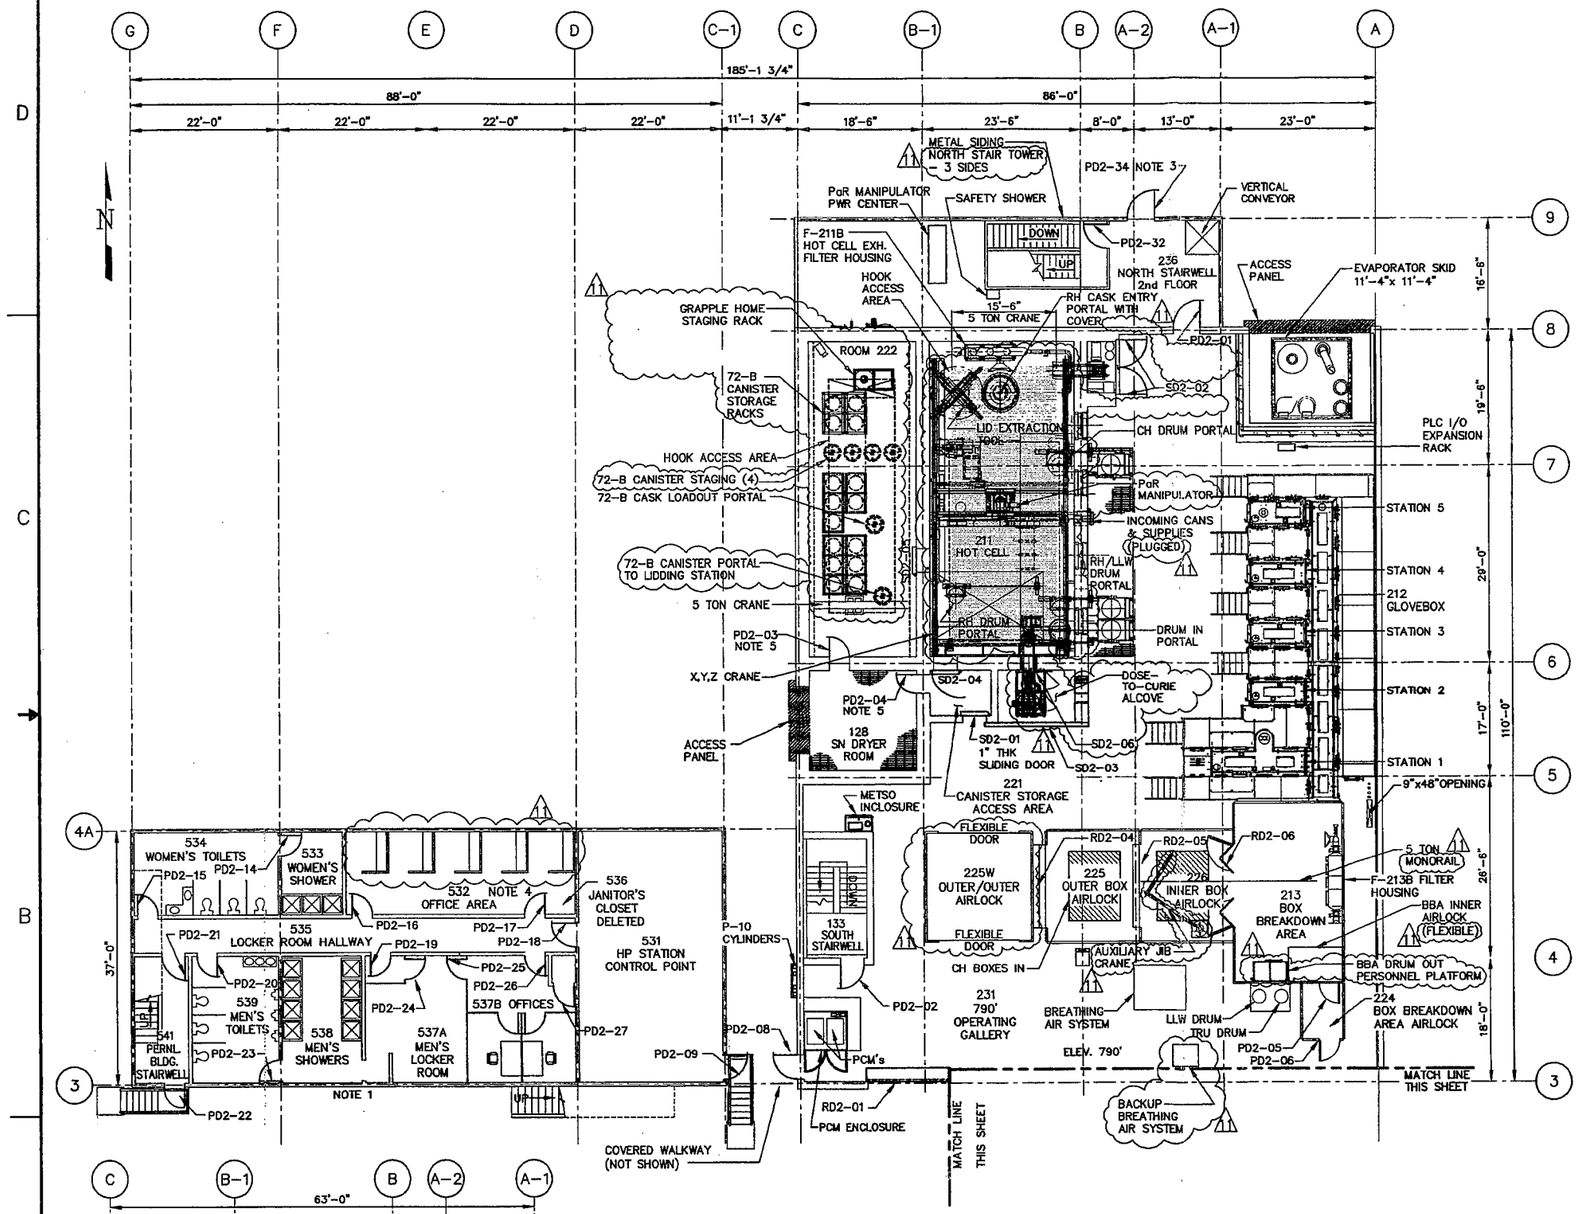

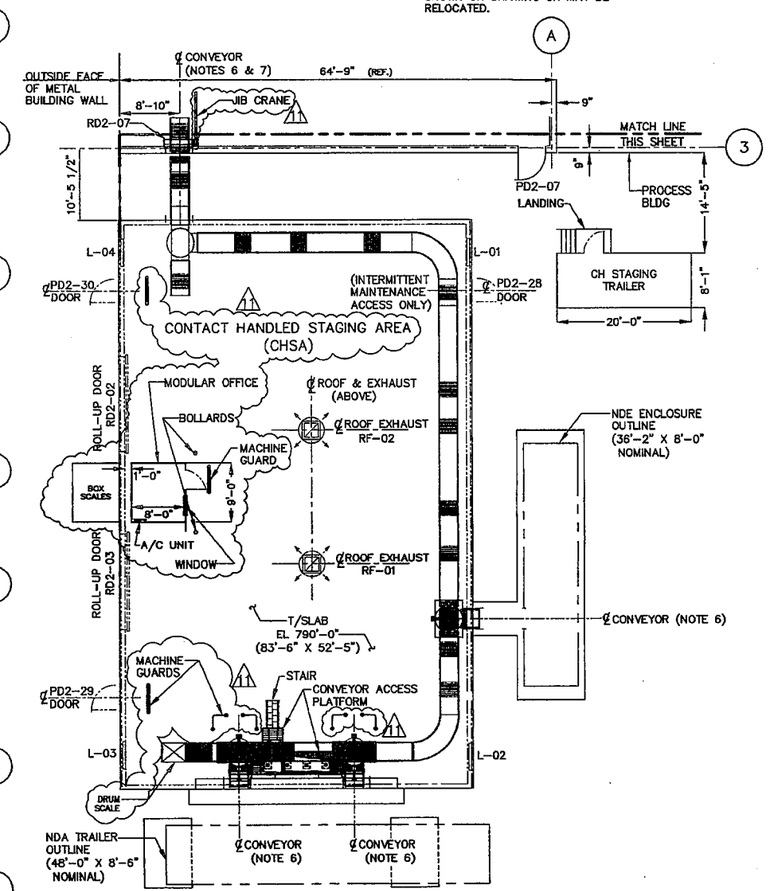

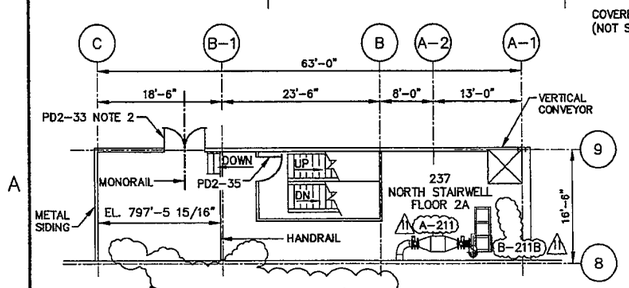

NORTH STAIRWELL INTERMEDIATE LEVEL EL. 798'-10"

REVISION NOTES:

1. ADDED CH STAGING TRAILER, RD2-07, AS BUILT NDA TRAILER & NDE ENCLOSURE LOCATIONS AND SLABS AND REVISED ROOM 212 GLOVEBOX FOOTPRINT.
2. REVISED ROOM 222 AND ROOM 211 LAYOUT BASED ON RH BUILDOUT REQUIREMENTS. ADDED JIB CRANES IN ROOM 226 AND ROOM 231. ADDED ROOM 225W. INCORP. DCN-ME-228, -233, -234, -237 R1, -243; DCN-SC-093. DCN-EE-184, R1 AND FCR-AR-001 WERE INCORP. IN PREVIOUS REVISIONS.

REV	DATE	BY	CHK'D	APR'VD	DESCRIPTION/ISSUE
11	9/26/06	JGM	CHK	CHK	SEE REVISION NOTES 2
10	10/5/05	EB	NG	GW	ADDED PCM ENCLOSURE, SAEFTY SHOWER, NOTE 8
					& REMOVED BBA/GB PASS THROUGH
9	6/21/05	JGM	NG	GW	SEE REVISION NOTES 1

RPE

DRAWN BY J. A. TABLER	DATE 12/1/00
DESIGNED BY J. G. WAGNER	DATE 12/1/00
CHECKED BY N. GHASSABIAN	DATE 12/1/00
APPROVED BY J. G. WAGNER	DATE 12/1/00
APPROVED BY	DATE

FOSTER WHEELER

FOSTER WHEELER ENVIRONMENTAL CORPORATION

TITLE

TRU/ALPHA WASTE TREAT. PROJ.
2ND FLOOR PLAN
GENERAL ARRANGEMENT

SIZE D | SCALE: 3/32"=1'-0" | SHEET: 1 OF 1 | DWG. NO. T-CM-FW-D-AR-002 | REV 11

FILENAME: T-CM-FW-D-AR-002